


LEGEND

- NEW ELEC, TELEPHONE, AND CABLE T.V. CONDUIT
- ELECTRIC MANHOLE
- G — NEW GAS LINE
- W — NEW WATER LINE
- X — WATER VALVE
- SS — NEW SAN. SEWER LINE
- SAN. SEWER MANHOLE
- I — SEWER SERVICE
- W — WATER SERVICE
- C — CABLE LINE
- T — TELEPHONE LINE
- E — ELECTRIC LINE
- TELEPHONE PEDESTAL
- △ CABLE PEDESTAL
- ELECTRIC TRANSFORMER

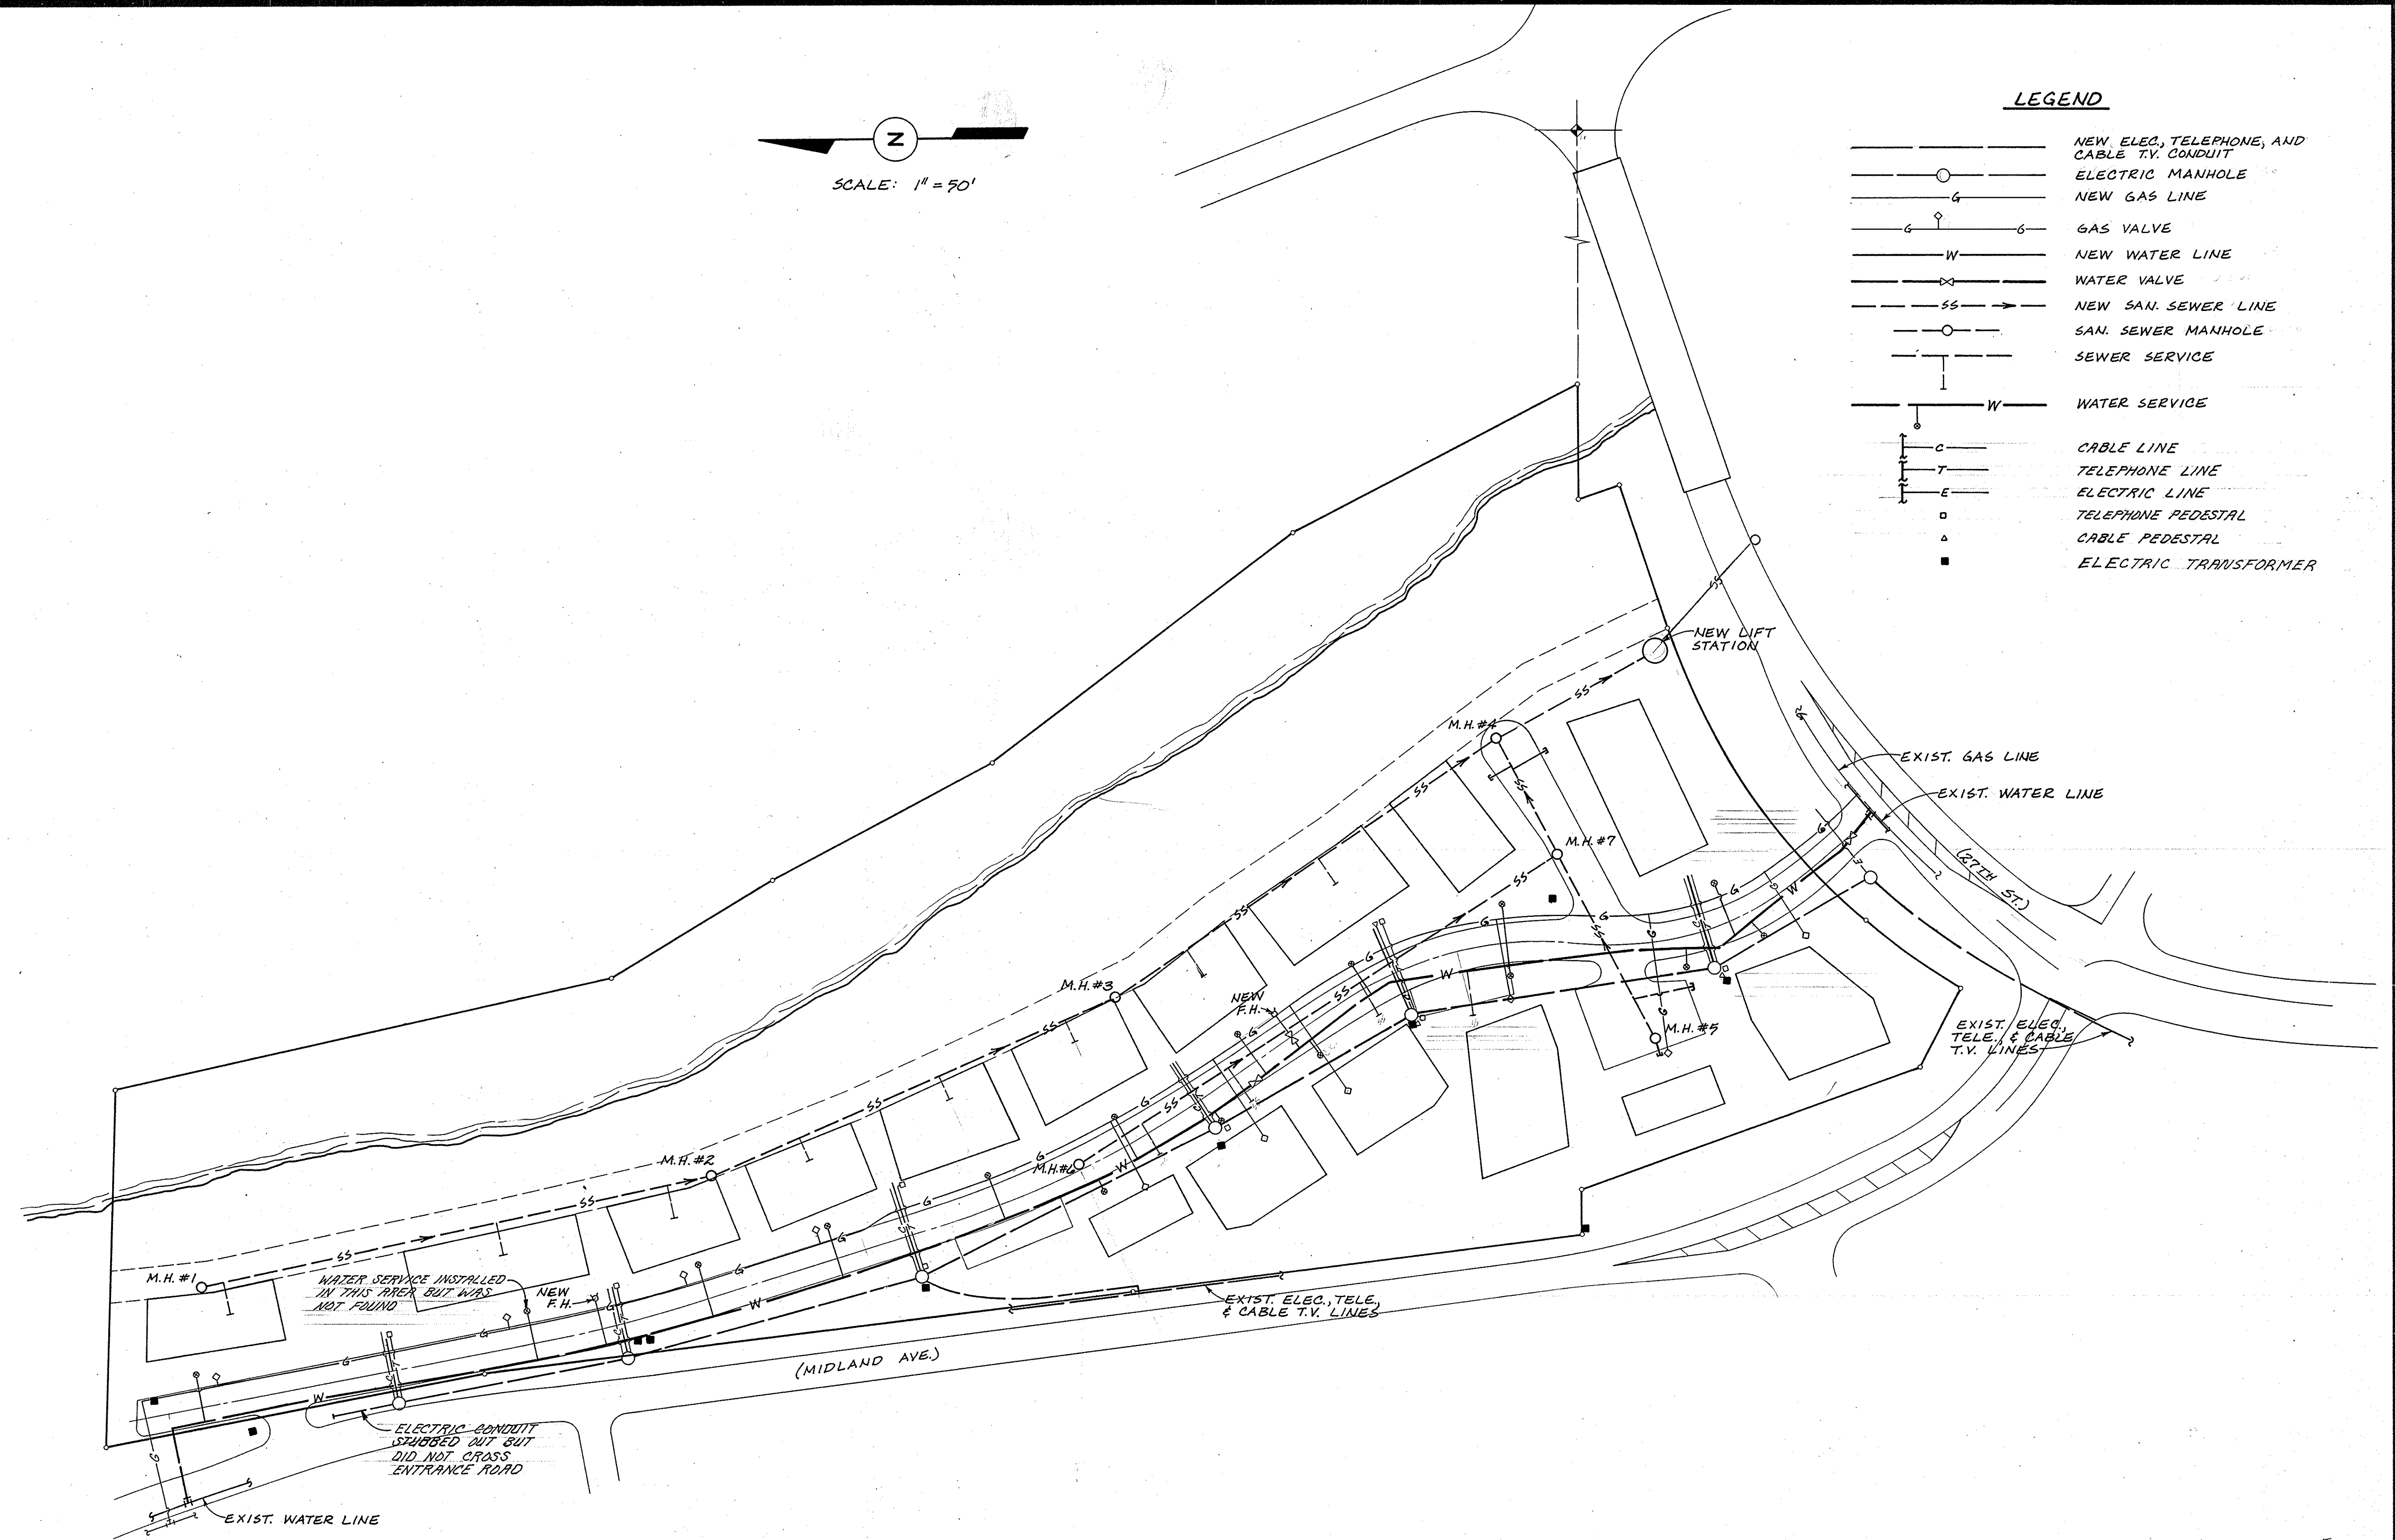

SCHMUESER & ASSOCIATES, INC.
 201 CENTENNIAL STREET
 GLENWOOD SPRINGS, COLORADO 81601
 (303) 945-5468

COTTONWOOD LANDING

Number	Revision	Date	By

AS-BUILTS

Job:	BROOIE
Drawn By:	S. R.
Date:	11-16-83
Appr:	